




Notes:
Contractor to check dimensions and notify any discrepancies or errors to MDA Architects Limited immediately.
Work to figured dimensions only. Do not scale. © All Rights Reserved.
This drawing where applicable must be read in conjunction with other relevant specifications and drawings

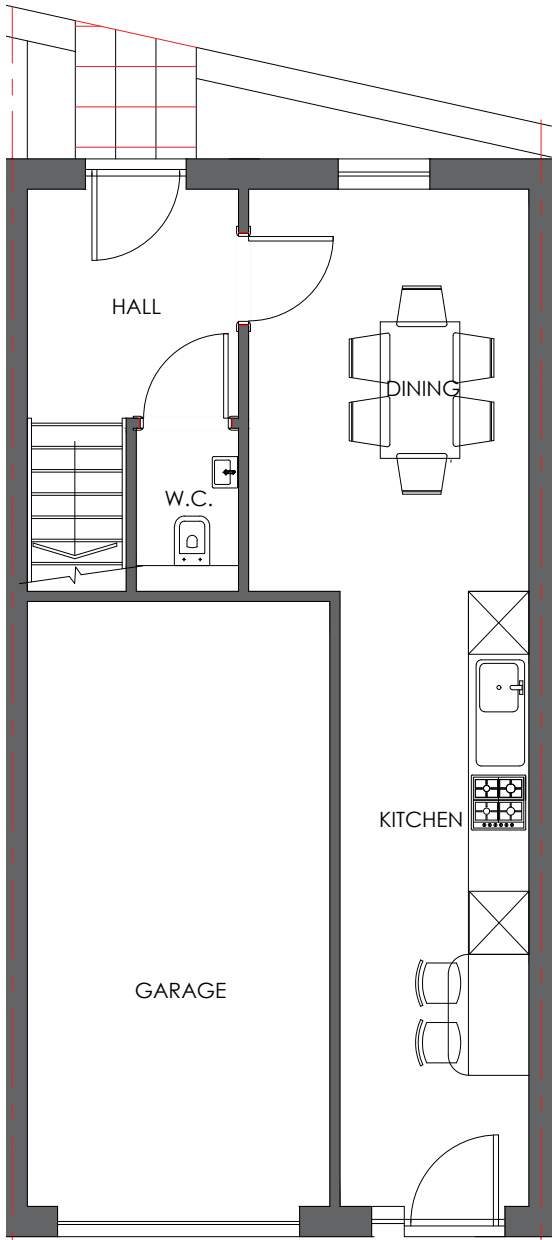


PLOT 7 GROUND FLOOR LAYOUT
SCALE 1:75 @ A3

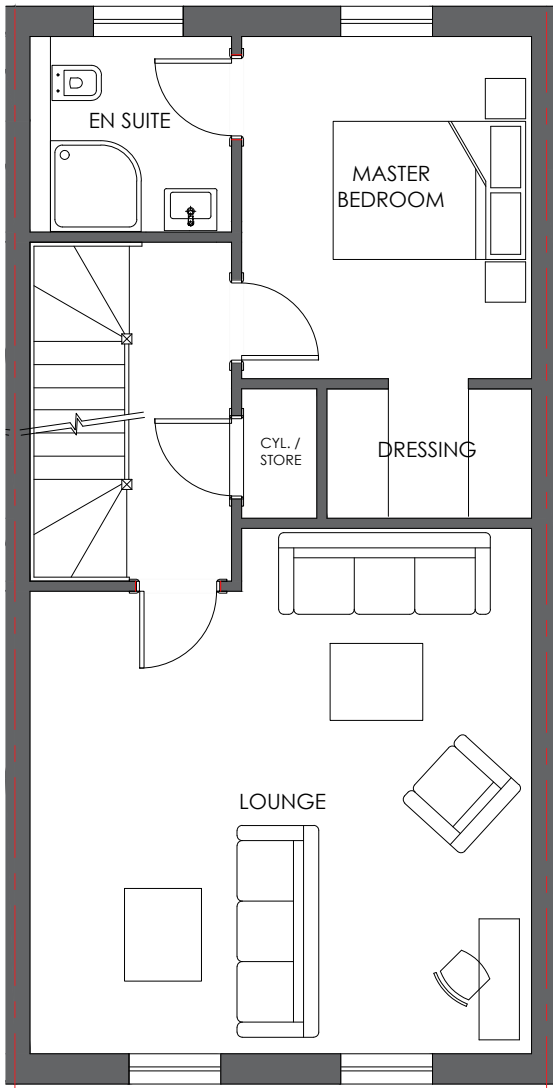


PLOT 7 FIRST FLOOR LAYOUT
SCALE 1:75 @ A3

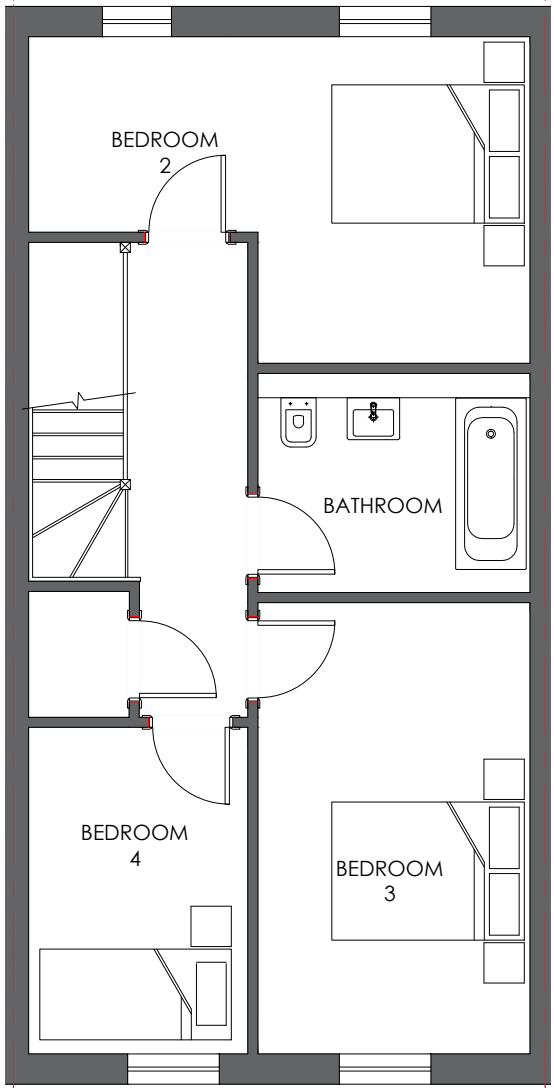


PLOT 7 SECOND FLOOR LAYOUT
SCALE 1:75 @ A3

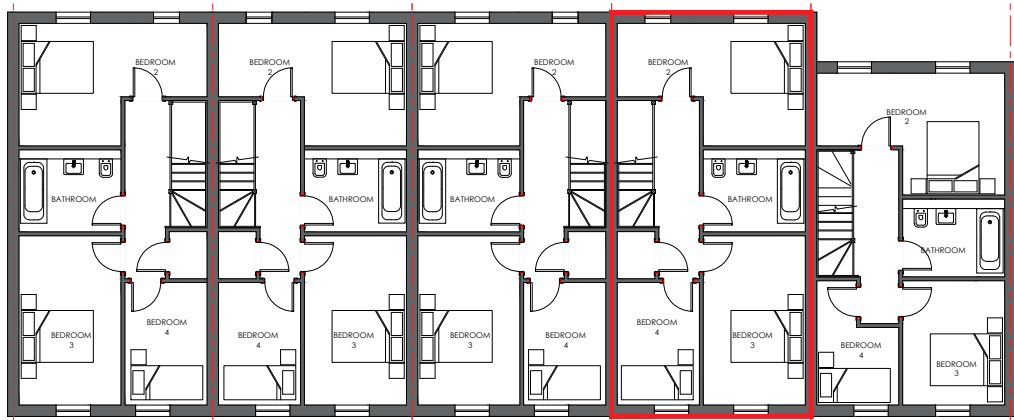

PLOTS 6 - 10 SECOND FLOOR BLOCK PLAN
SCALE 1:200 @ A3

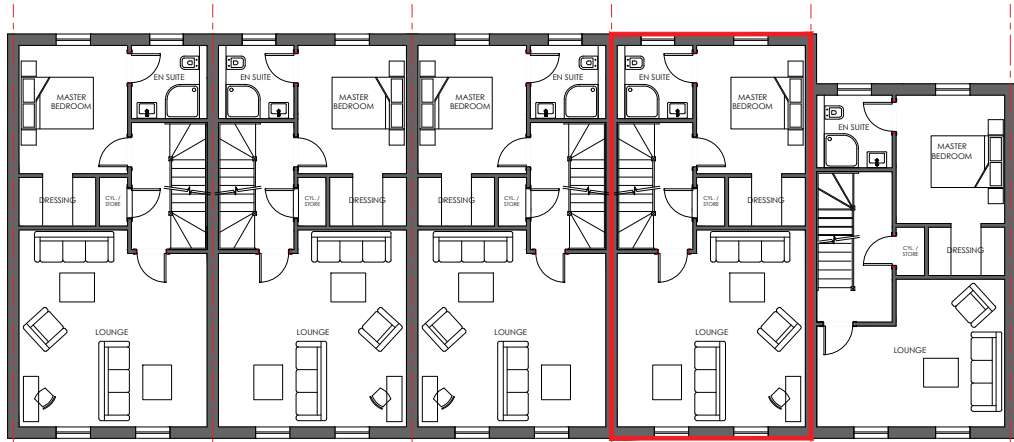

PLOTS 6 - 10 GROUND FLOOR BLOCK PLAN
SCALE 1:200 @ A3

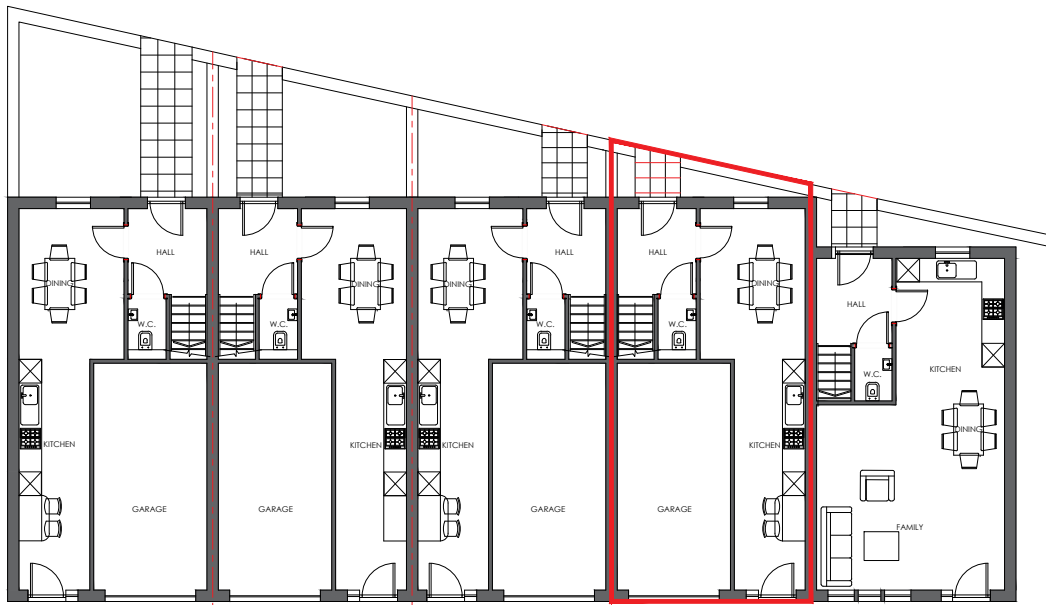

PLOTS 6 - 10 GROUND FLOOR BLOCK PLAN
SCALE 1:200 @ A3

rev	description	drawn	auth	date
-----	-------------	-------	------	------

AS BUILT DRAWING

MORETON DEAKIN ASSOCIATES
architecture

the turret
valley road
hebden bridge
west yorkshire
hx7 7bz
tel: +44(0) 1422 844762
fax: +44(0) 1422 845758
email: info@mdaarchitects.co.uk

client



Torsion Homes
1280 Century Way
Thorpe Park, Leeds
LS15 8ZB

project

**PROPOSED RESIDENTIAL DEVELOPMENT
VALLEY ROAD / HANGINGROYD LANE
HEBDEN BRIDGE**

description

**PLOT 7 VALLEY ROAD
LAYOUT PLANS**

scale

1:50 / 1:100 @ A3

drawn by

GRT

authorised by

SMD

project no

1880

date drawn

Aug 2024

drawing no

VR-S-P7

rev

-